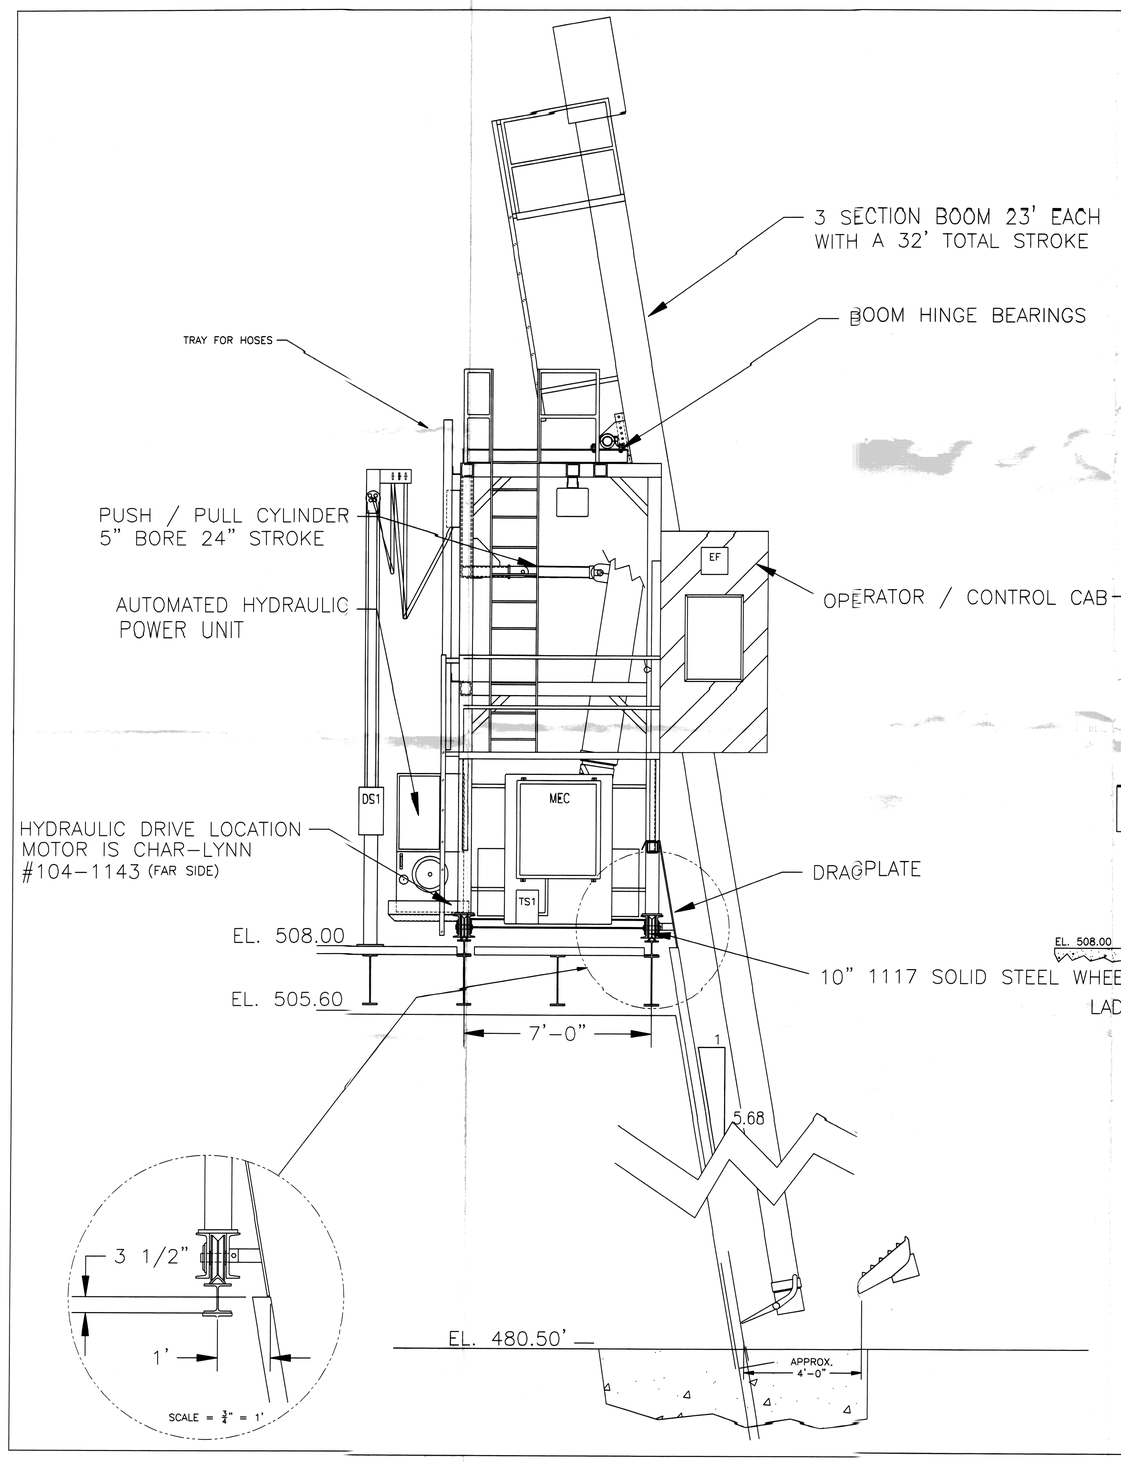

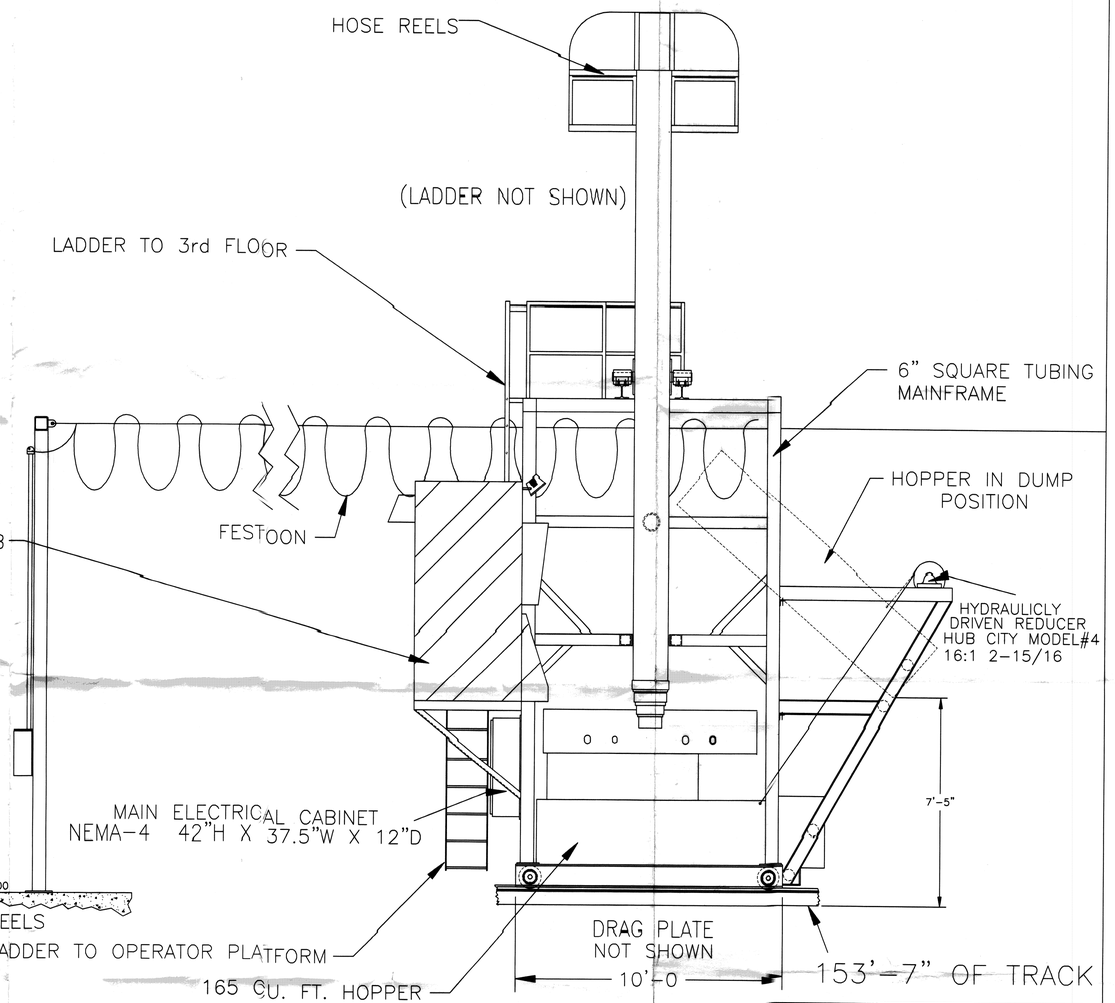

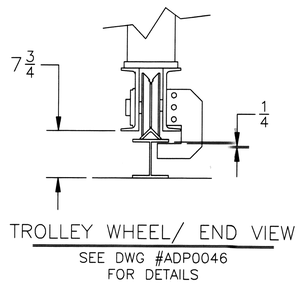

DATE	REVISION	BY	APPROVED
10/23/97	AS BUILT	RLF	
7/8/97	DISCONNECT/ FESTOON LADDER PLACEMENT/ RAILING/BOOM GUIDE	ADP	
8/10/97	RACK ANGLE CHANGE	ADP	

CROSS MACHINE INC. BERLIN,NH

NOTE: THIS DRAWING AND THE PRODUCTS METHODS DESCRIBED HEREIN ARE THE PROPRIETARY RIGHT OF CROSS MACHINE, INC. REPRODUCTION OF DRAWINGS OR ANY USE BEYOND GENERAL REFERENCE AND CONTRARY TO THE OWNER'S BEST INTEREST SHALL BE IN VIOLATION OF UNITED STATES PATENT LAW.

DO NOT SCALE DRAWING

WATERTOWN HYDROELECTRIC PROJECT
HYDRO RAKE GENERAL ARRANGEMENT
CITY OF WATERTOWN NY

DATE: 6-3-97	SCALE: 3/8"=1'-0
DRAWN BY: adp0002	APPROVED BY: MB
DRAWING NUMBER: D-000466	

Hoppe Dam 8-10